

- △ 11.15.06 WINDOWS AND DOORS, RAMPS AND PLANTERS
- △ 08.23.06 WINDOWS AND DOORS, ARCH. LIGHTING
- △ 07.31.06 INSULATING CONCRETE FORMS
- △ 06.13.06 RESPONSE TO FIRST PLAN CHECK

REVISIONS


07.31.06 DATE

MR/VJ/TT DRAWN


AS NOTED  
SCALE

**EXTERIOR DETAILS**


TITLE  
**A7.2**  
SHEET NO.

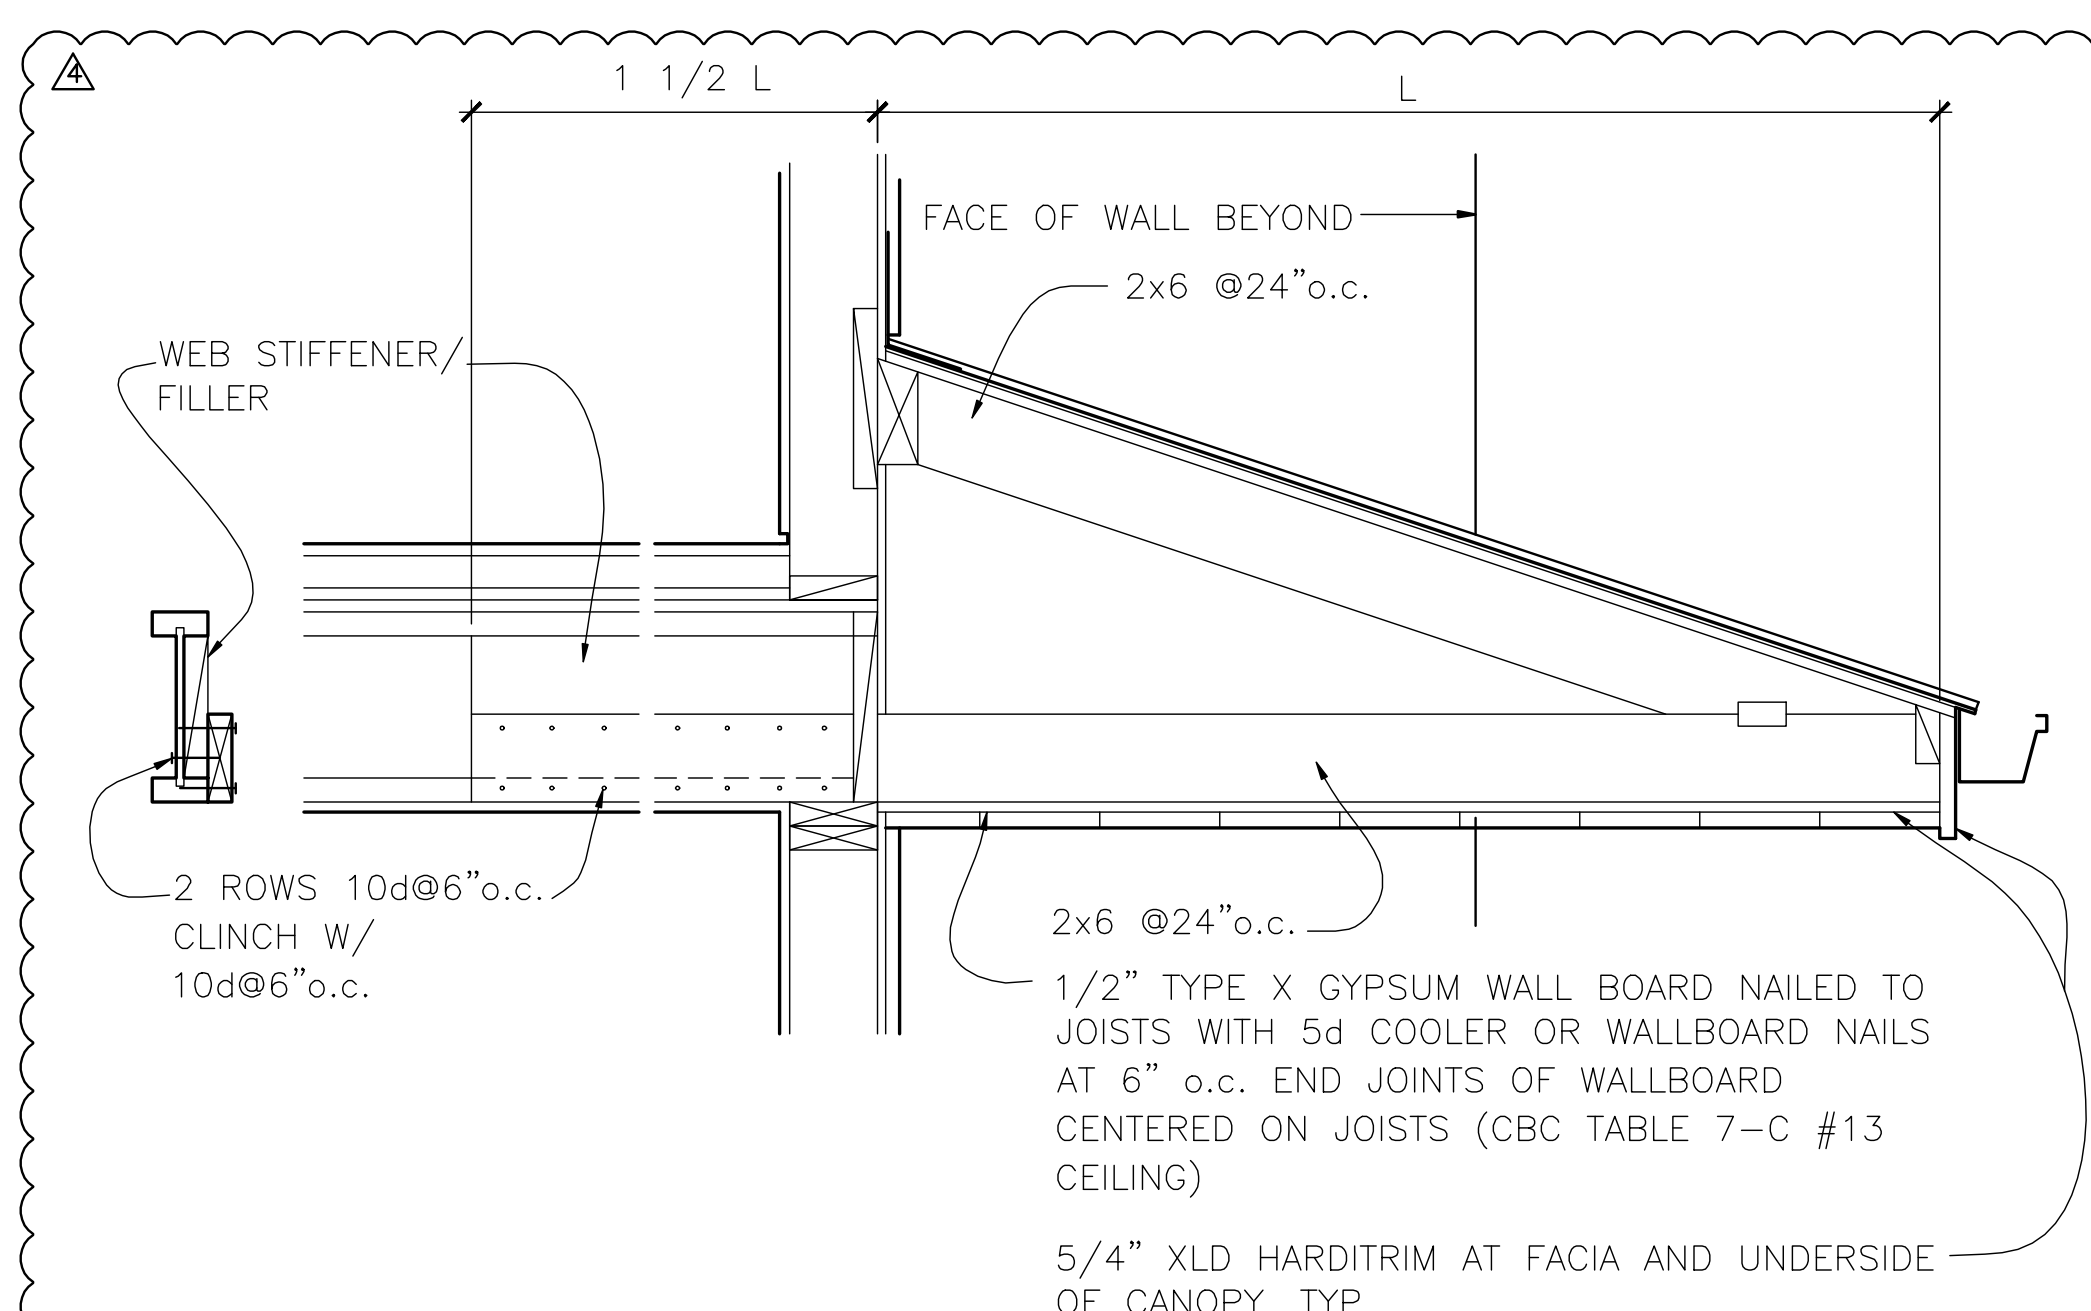


**6 CANOPY DETAIL**  
A7.2

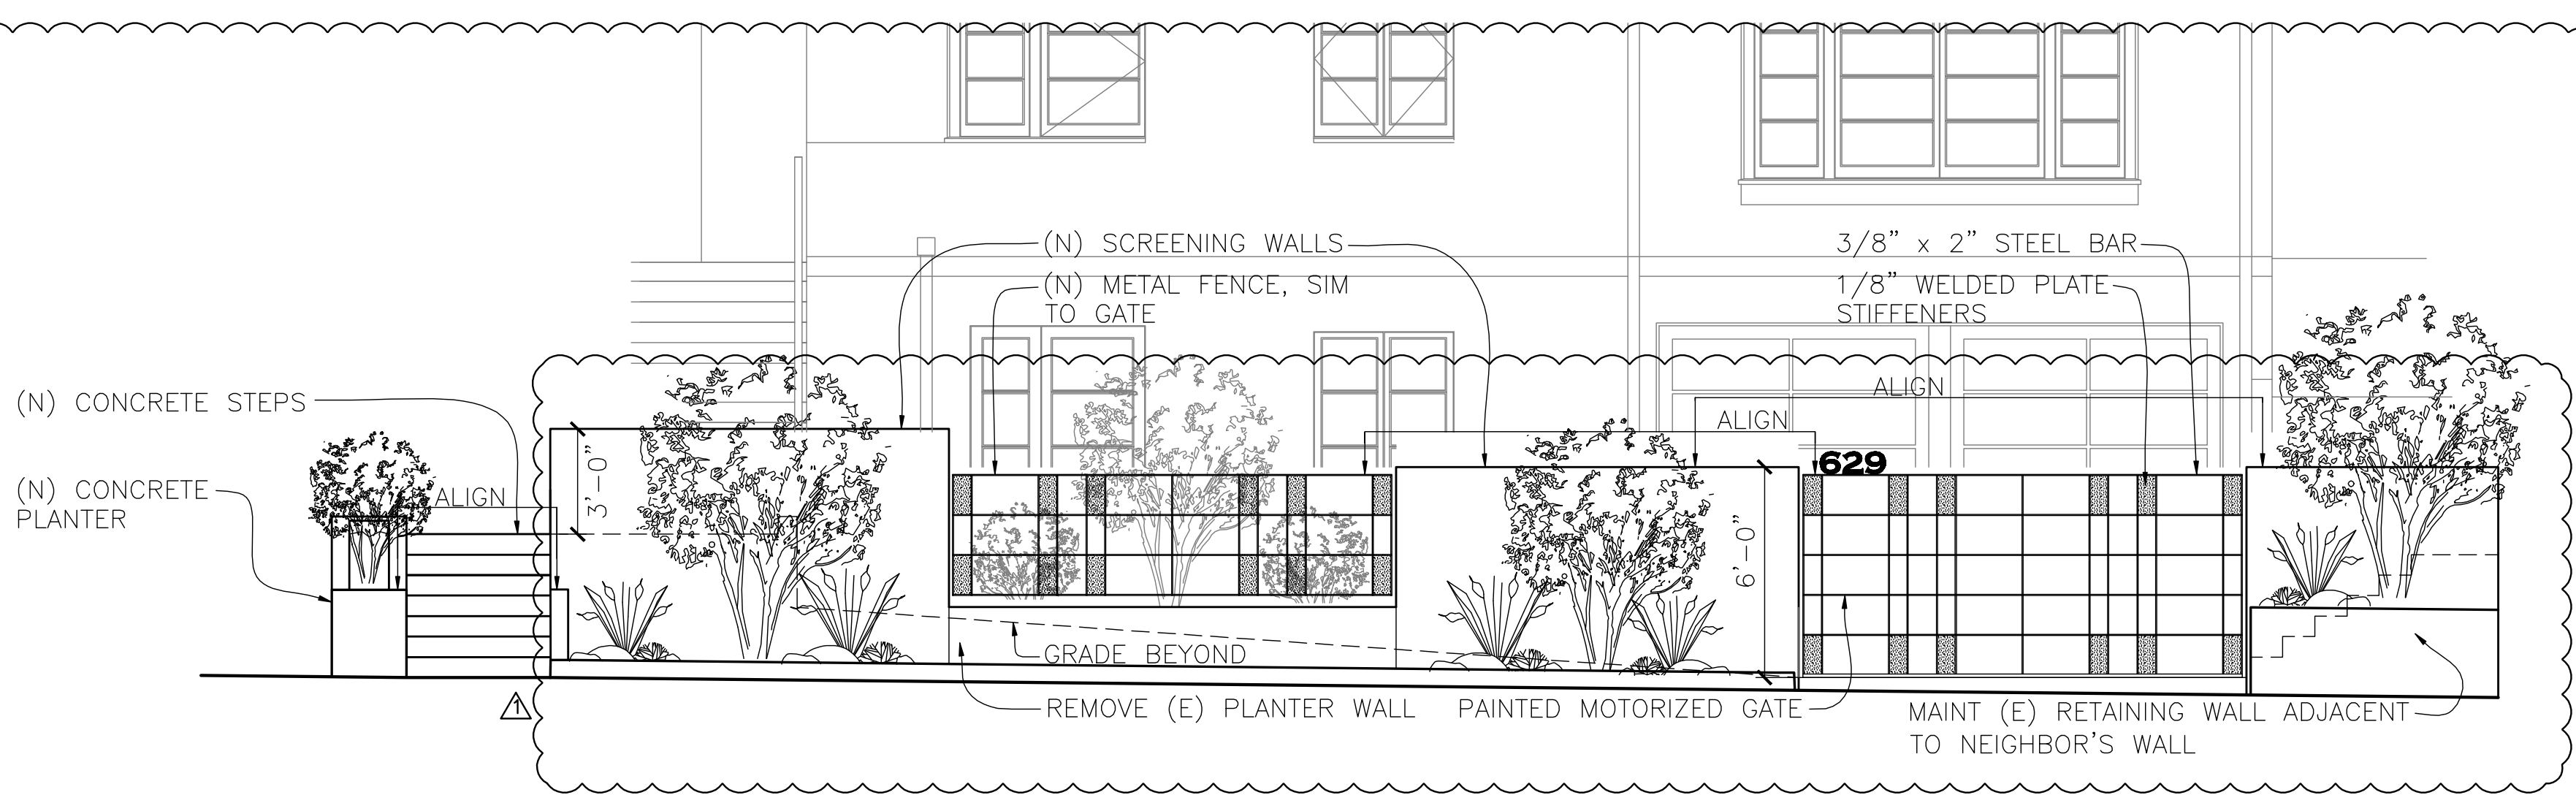


**5 WEST ELEVATION - LANDSCAPING AT STREET**  
A7.2

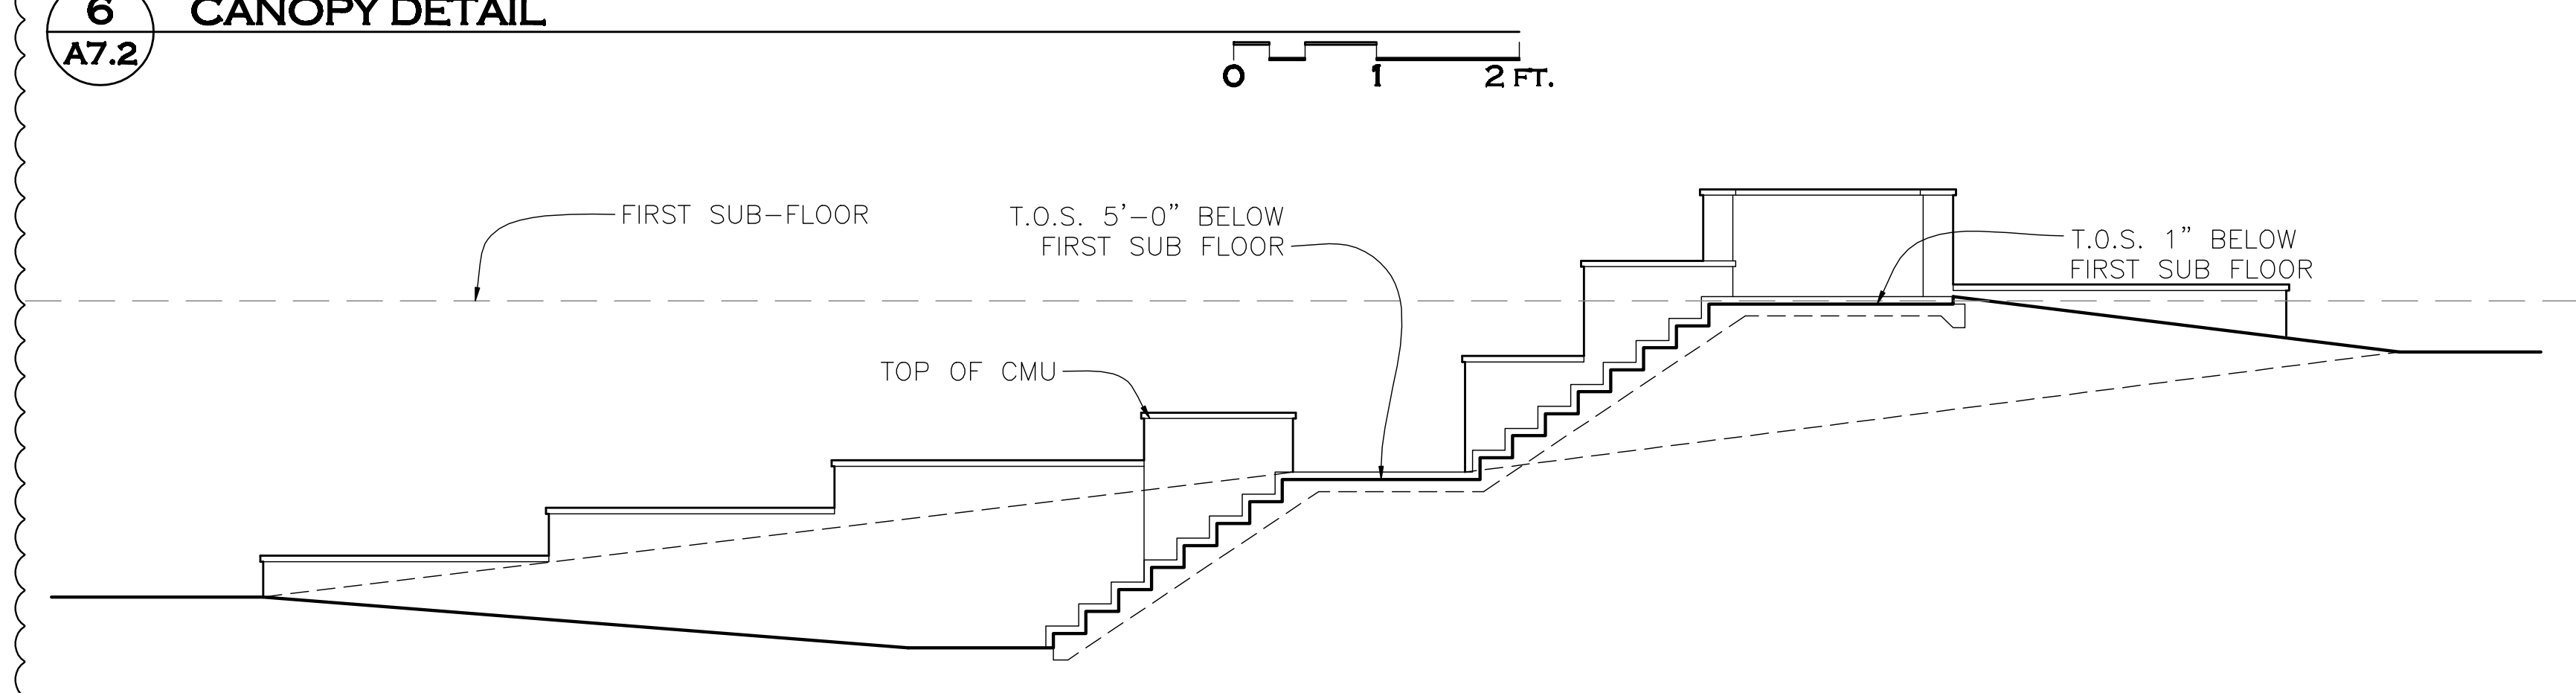


**4 EAST-WEST PLANTER SECTION**  
A7.2

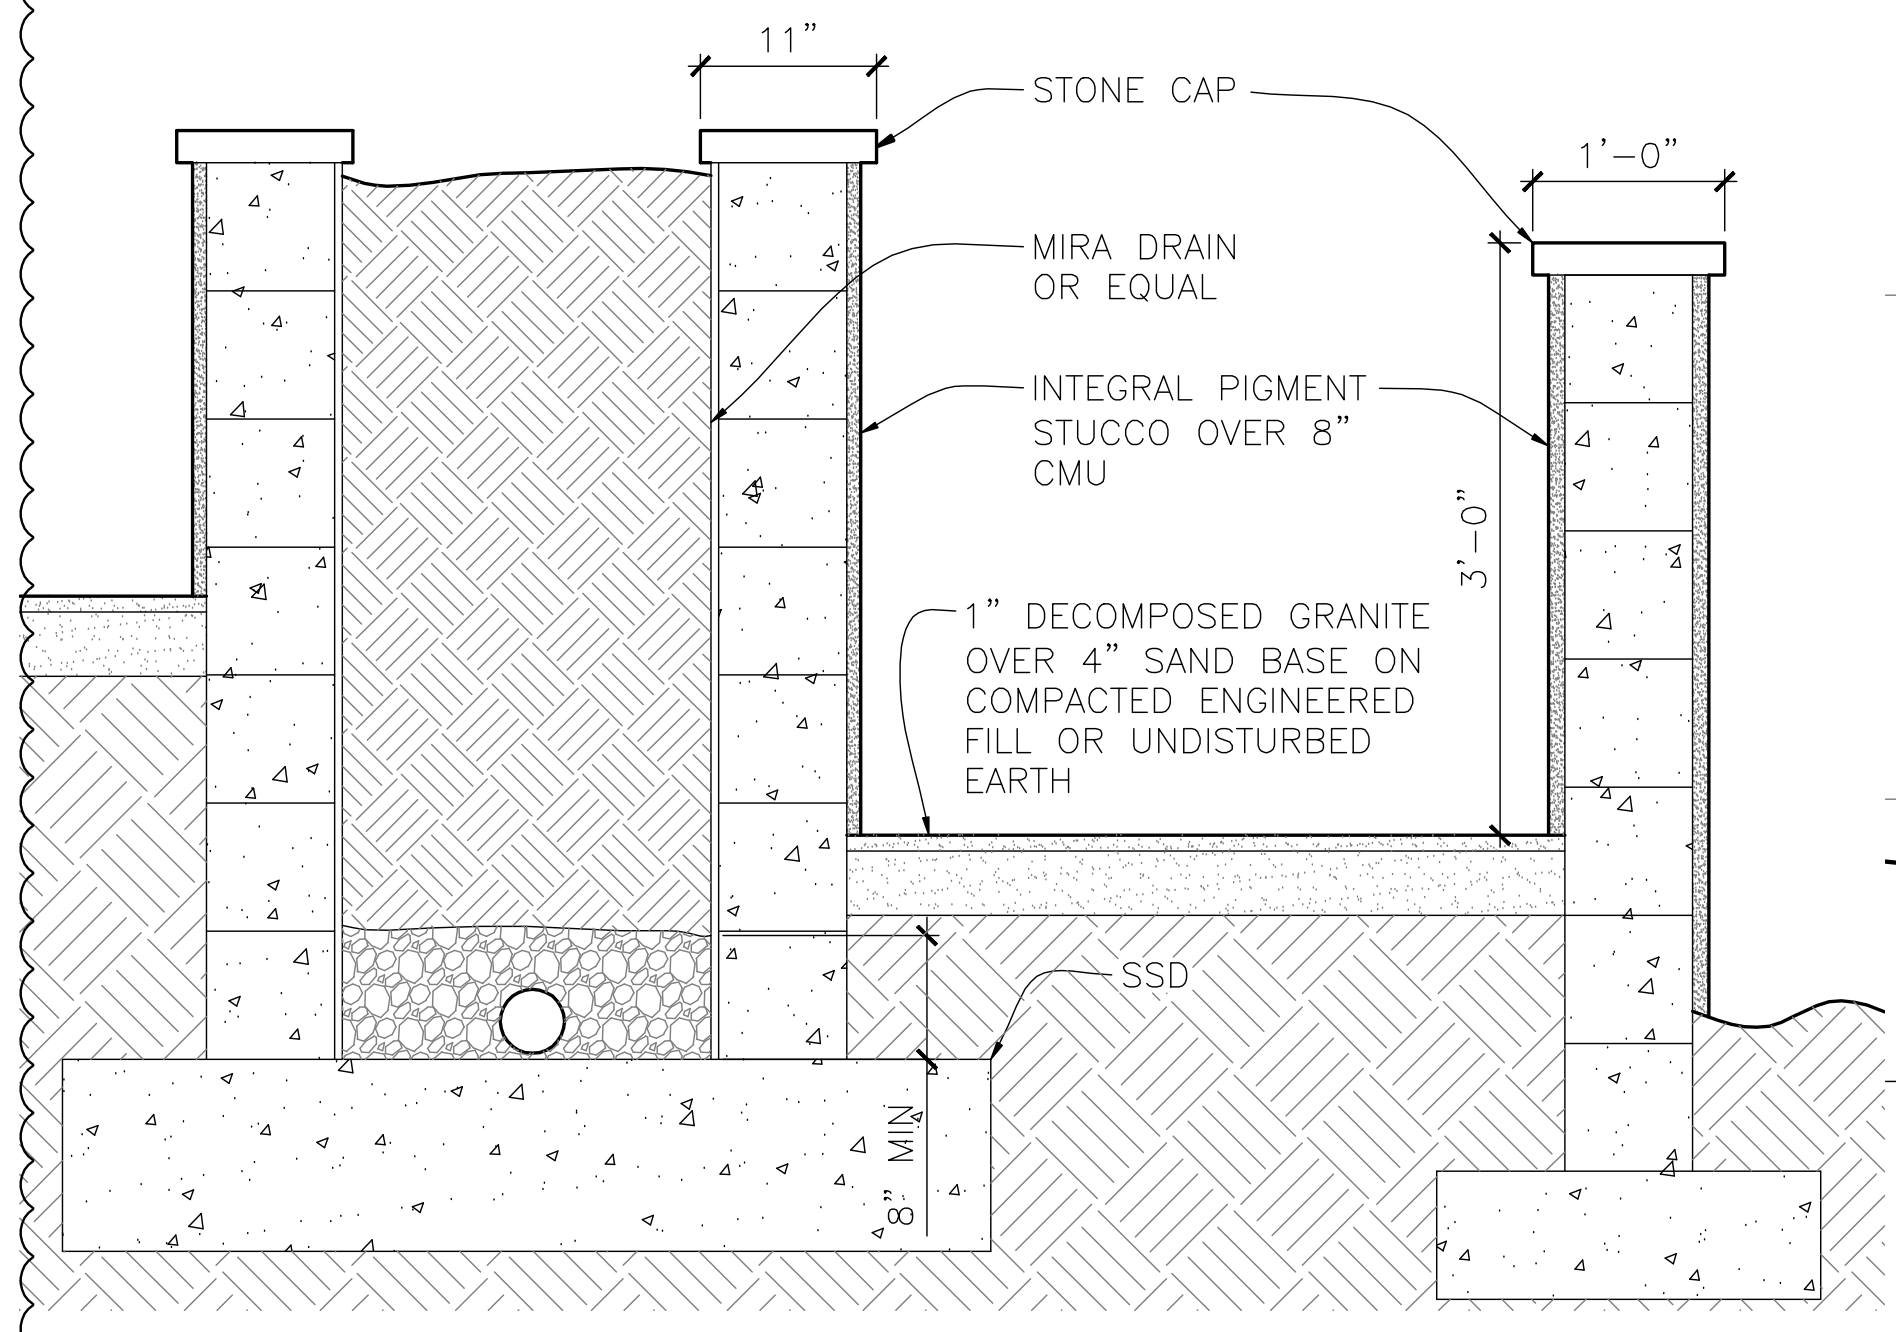

**2 TYPICAL PLANTER AND WALL SECTIONS**  
A7.2

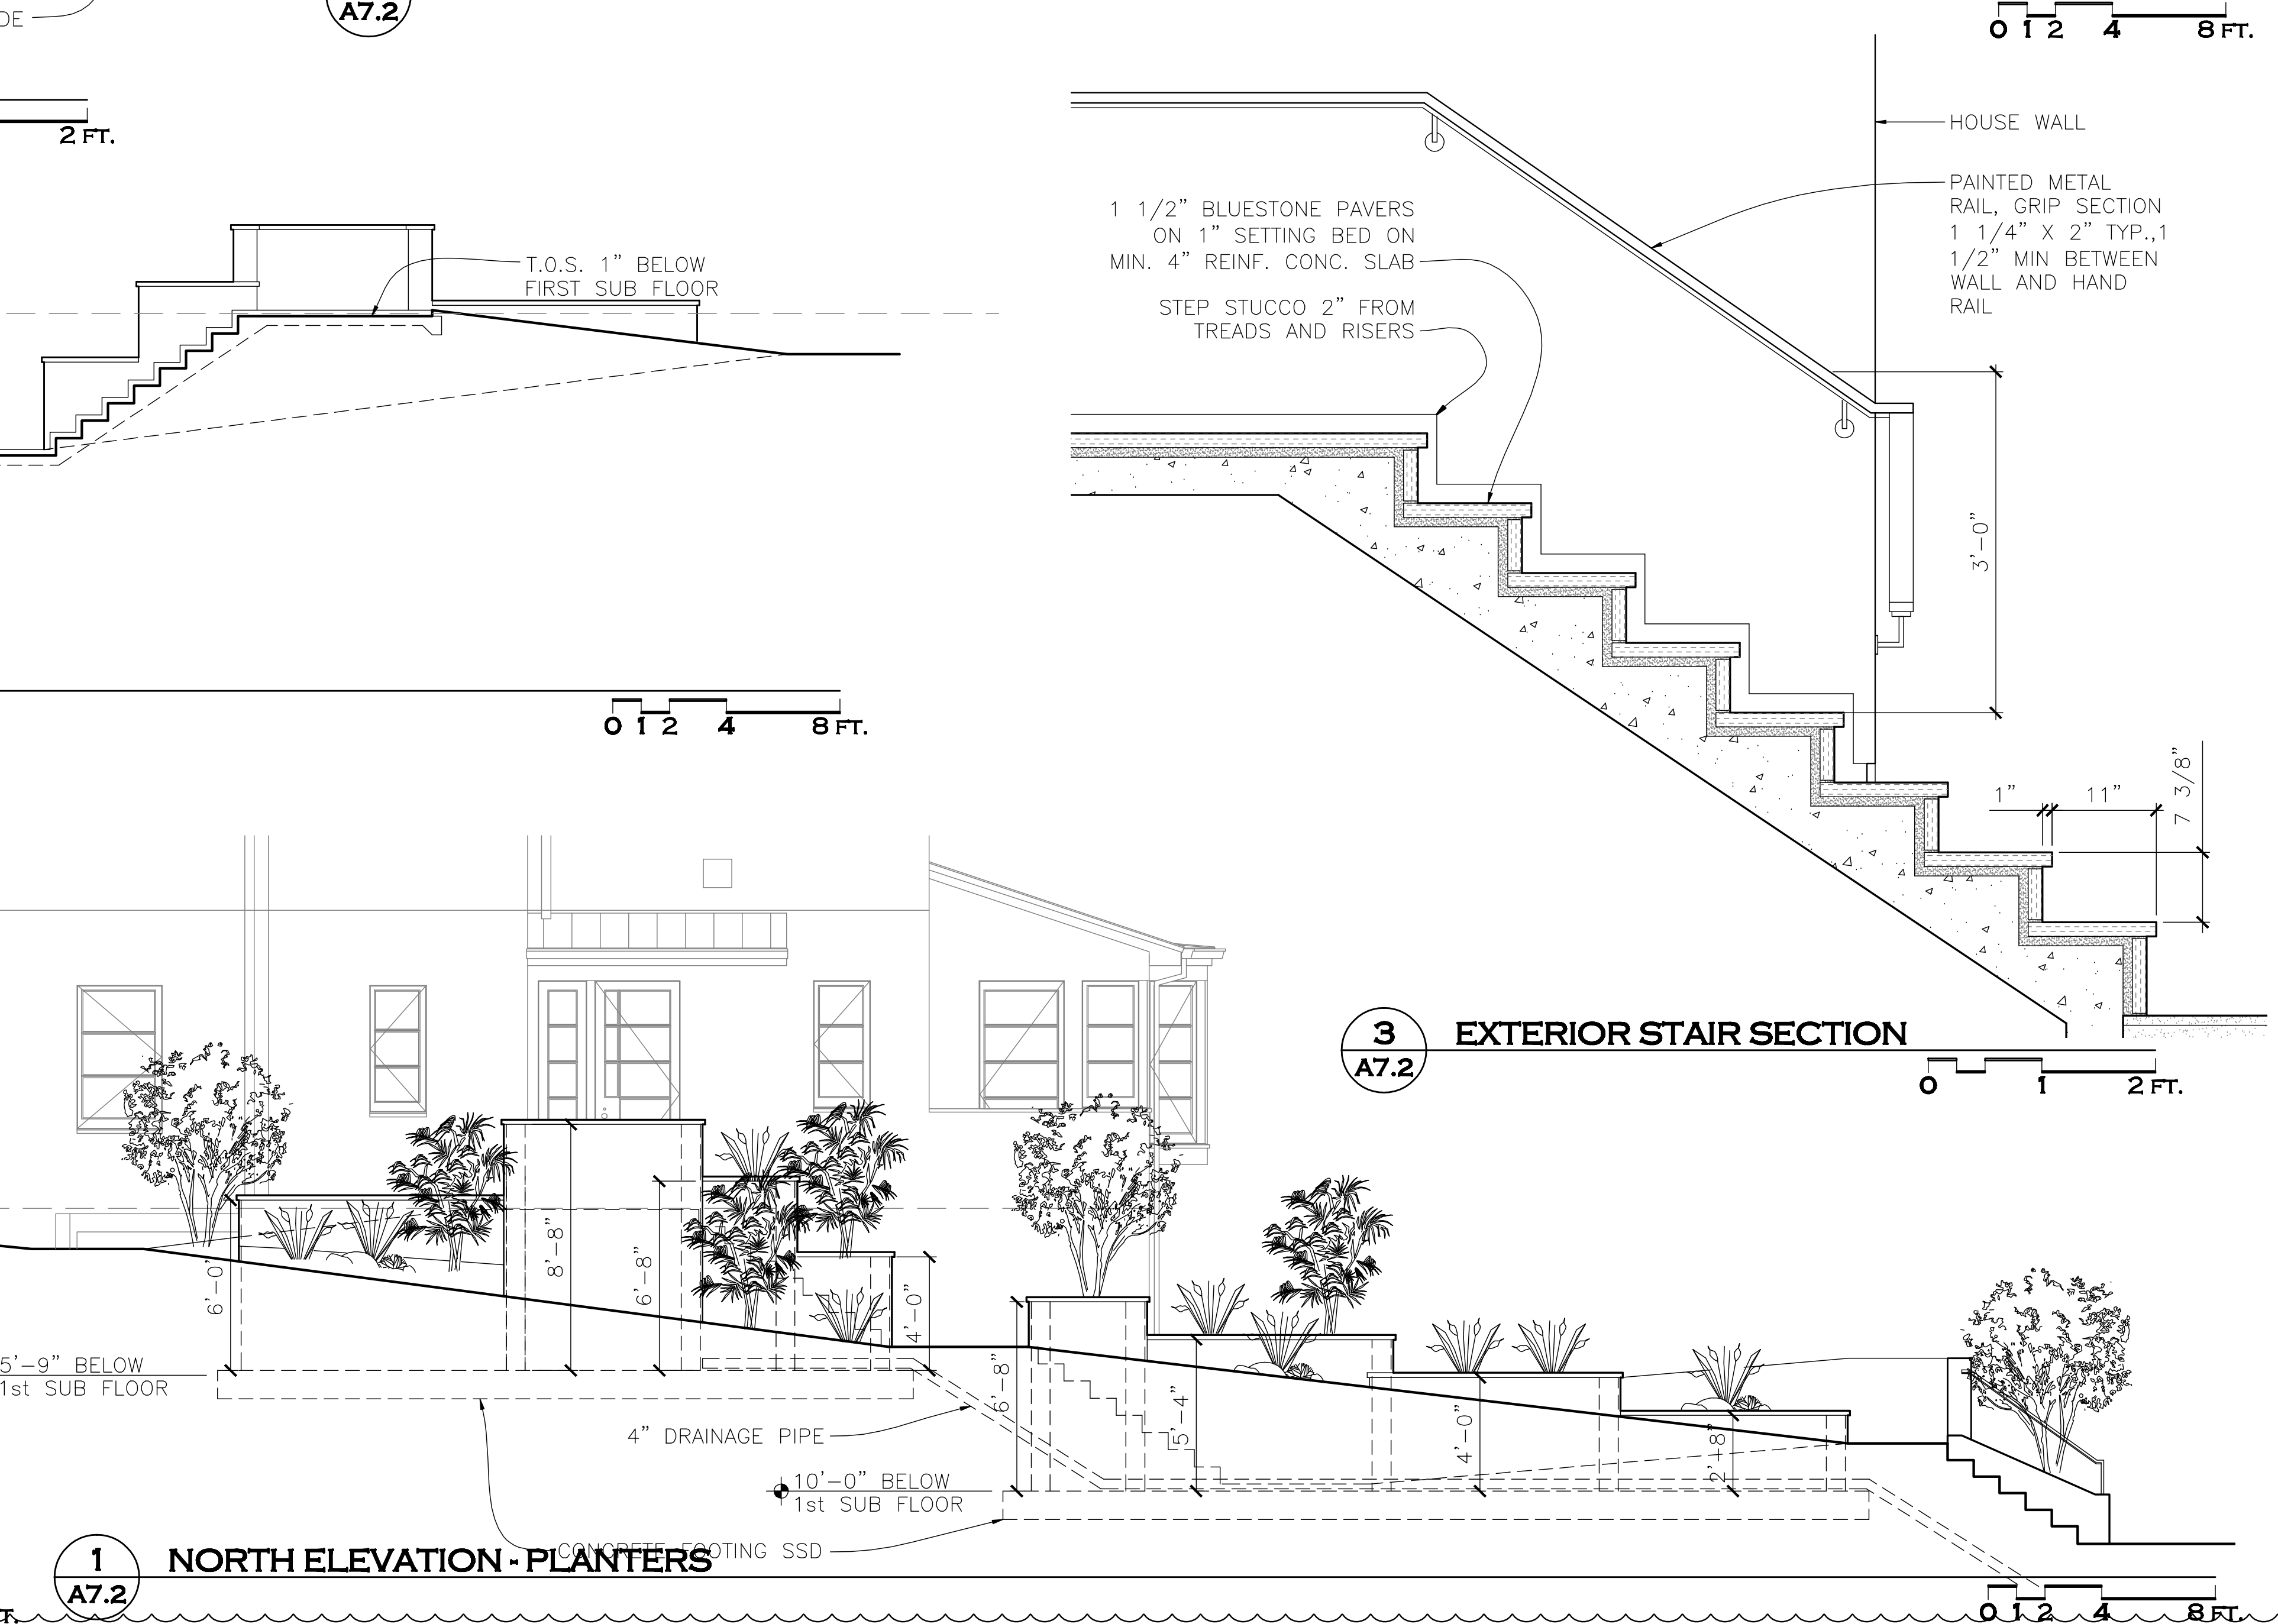

**3 EXTERIOR STAIR SECTION**  
A7.2

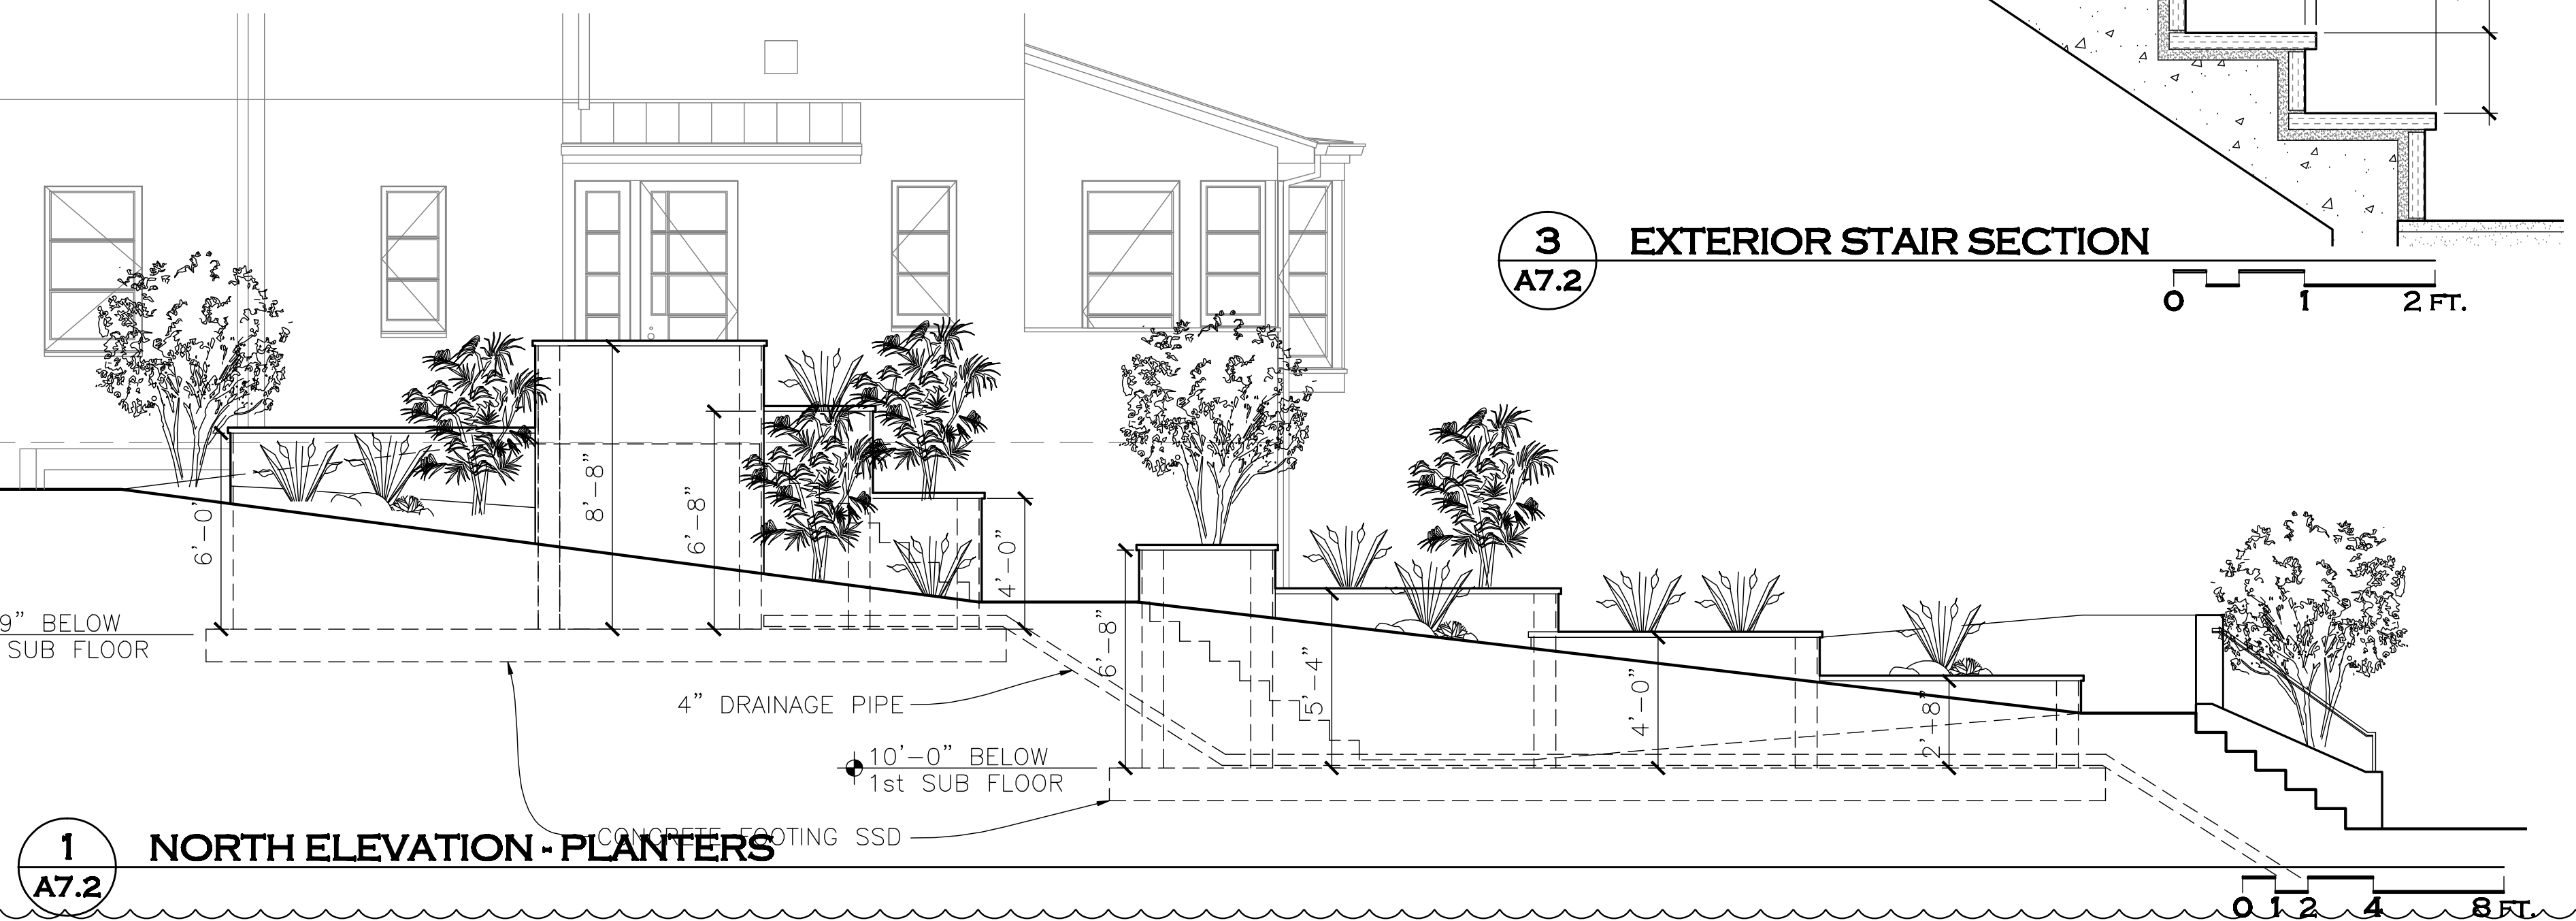

**1 NORTH ELEVATION - PLANTERS**  
A7.2